



AS-BUILT CERTIFICATION  
30 TAYLOR RIVER ESTATES  
HAMPTON, NH  
SCALE: 1"=20' SEPT 29, 2016

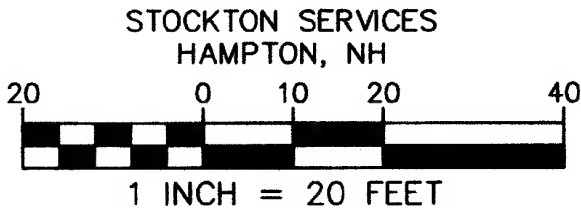

THE PURPOSE OF THIS PLAN IS TO  
CERTIFY TO NEW STRUCTURE SETBACKS.  
NO OTHER REPRESENTATION IS INTENDED  
OR IMPLIED.

OWNER OF RECORD:  
DONNA M. DEMARCO  
30 TAYLOR RIVER ESTATES  
HAMPTON, NH 03842

TAX MAP 184 LOT30  
ZONING CLASS: G  
RCL AREA: 16082 SF±  
RCRD 3314-2173  
RCRD PLAN D17786  
RCRD PLAN D21018

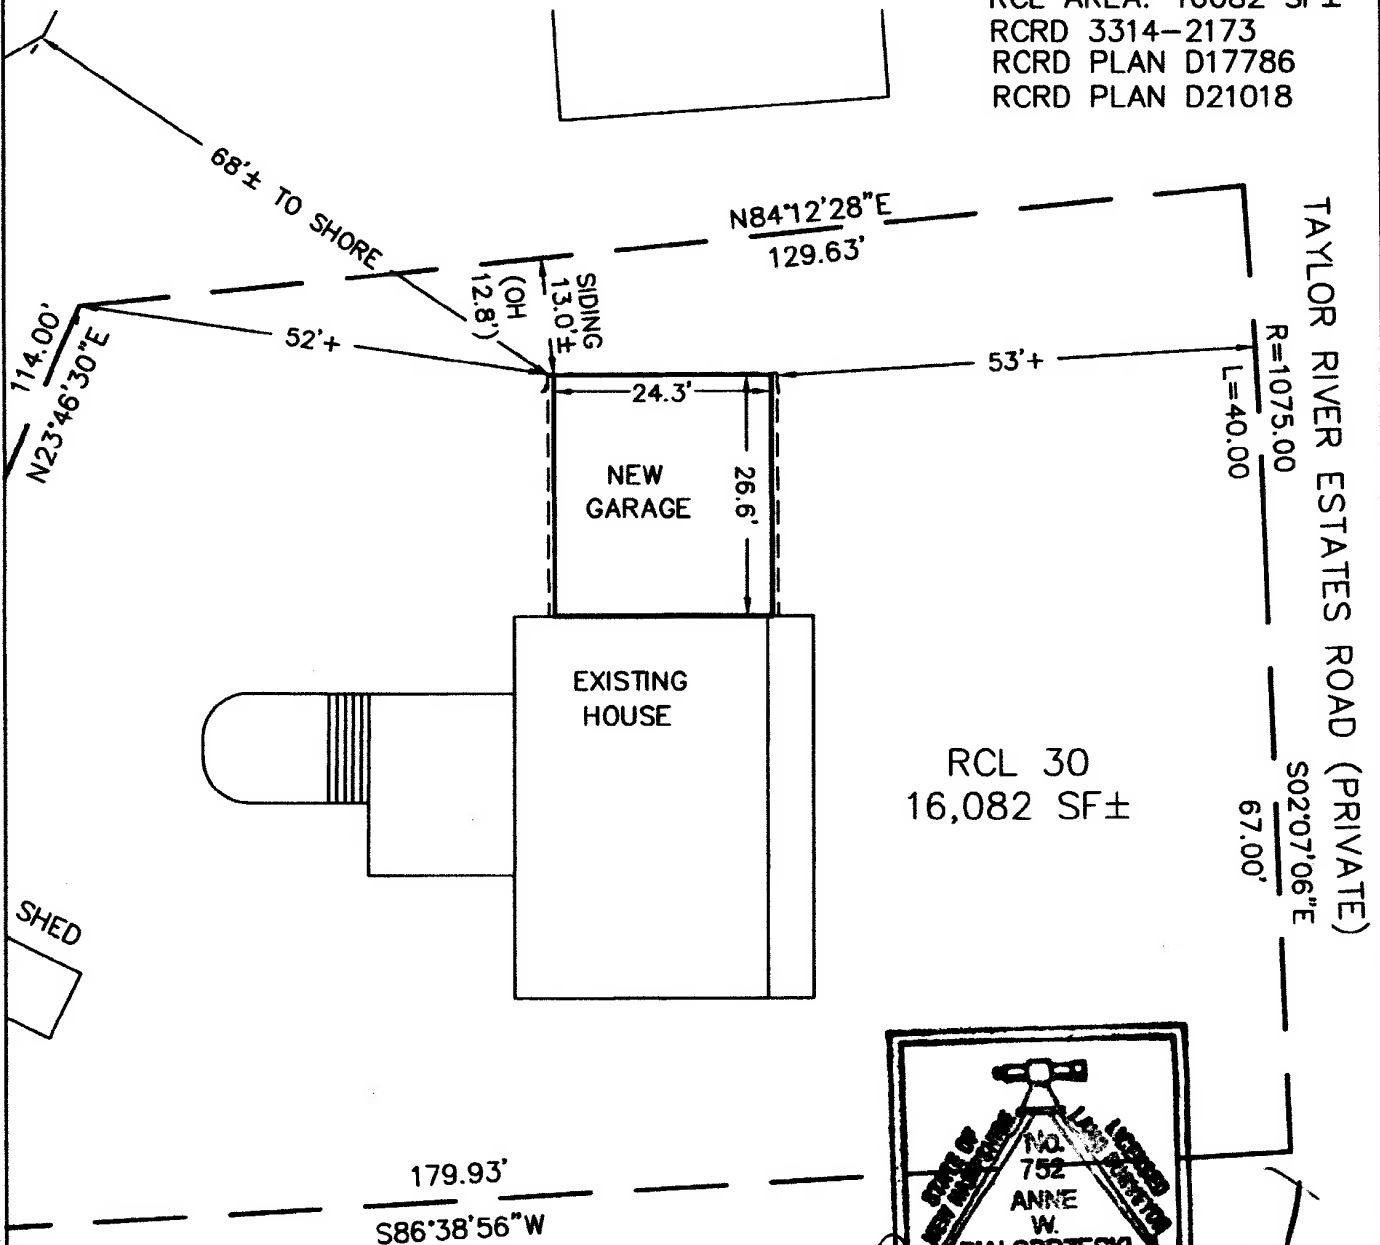

9/29/16

RCL AREA DOES NOT LIE WITHIN A FEDERALLY  
DESIGNATED FLOOD HAZARD ZONE.